


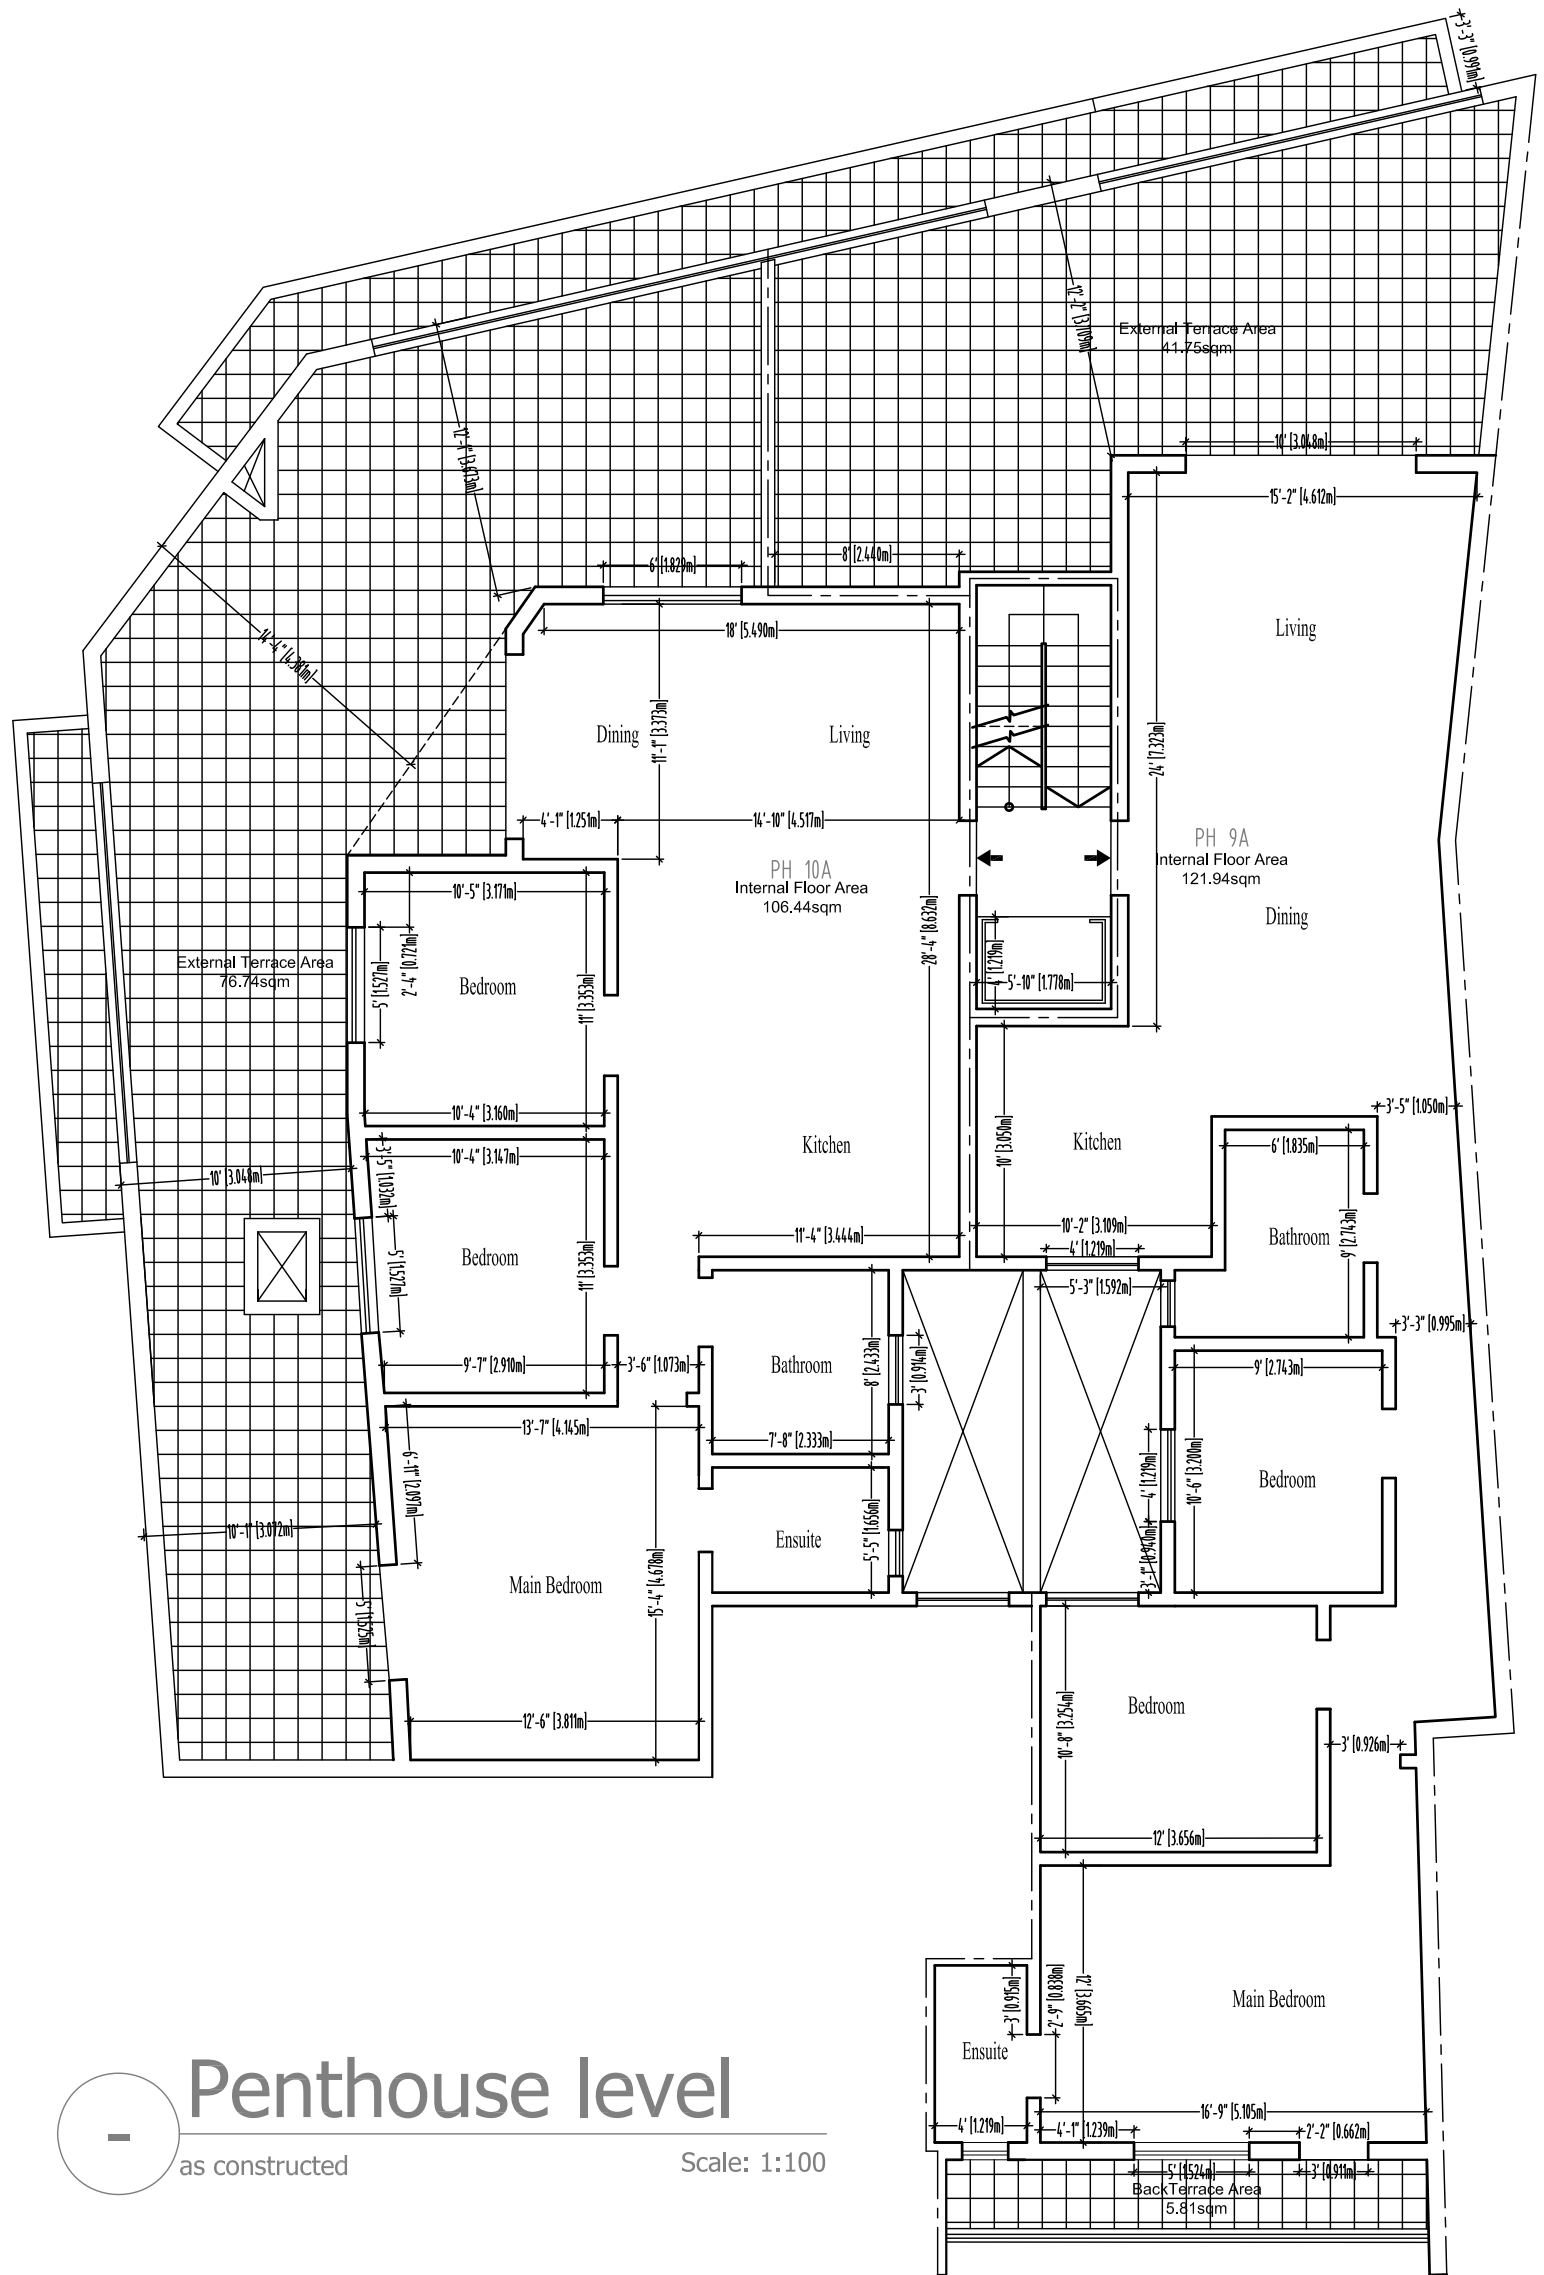

Penthouse level
as constructed Scale: 1:100